



## Availabilities


1840 S Stapley Dr

### As Built

### RSF

Suite 201

28,978

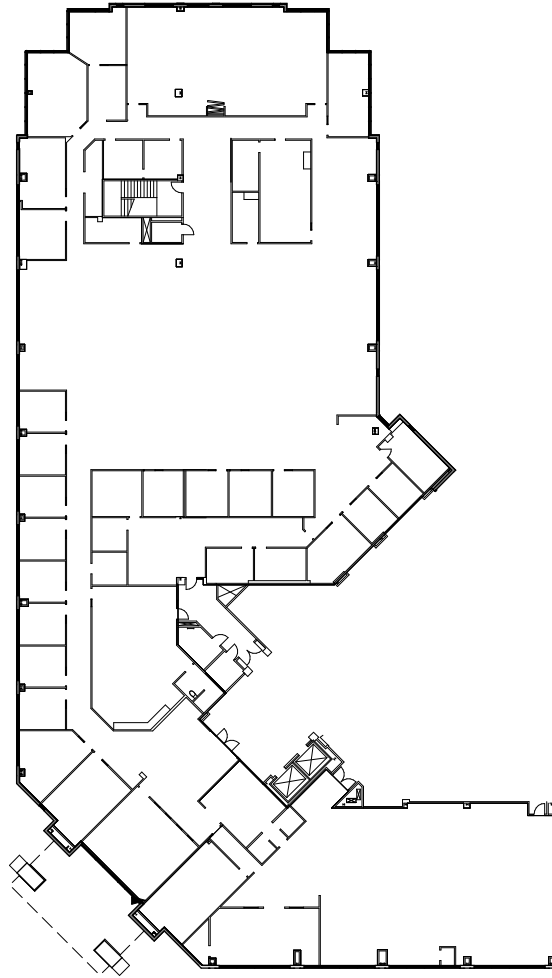

For leasing information contact

**Rachael Thompson**

602.513.5122

[rachael.thompson@kidder.com](mailto:rachael.thompson@kidder.com)

**Perry Gabuzzi, CCIM**

602.513.5116

[perry.gabuzzi@kidder.com](mailto:perry.gabuzzi@kidder.com)

[stapleymedicalcenter.com](http://stapleymedicalcenter.com)



**CYPRESS**  
OFFICE PROPERTIES



This information supplied herein is from sources we deem reliable. It is provided without any representation, warranty or guarantee, expressed or implied as to its accuracy. Prospective Buyer or Tenant should conduct an independent investigation and verification of all matters deemed to be material, including, but not limited to, statements of income and expenses. Consult your attorney, accountant, or other professional advisor.