


**As Built**

**RSF**

Suite 127

1,493

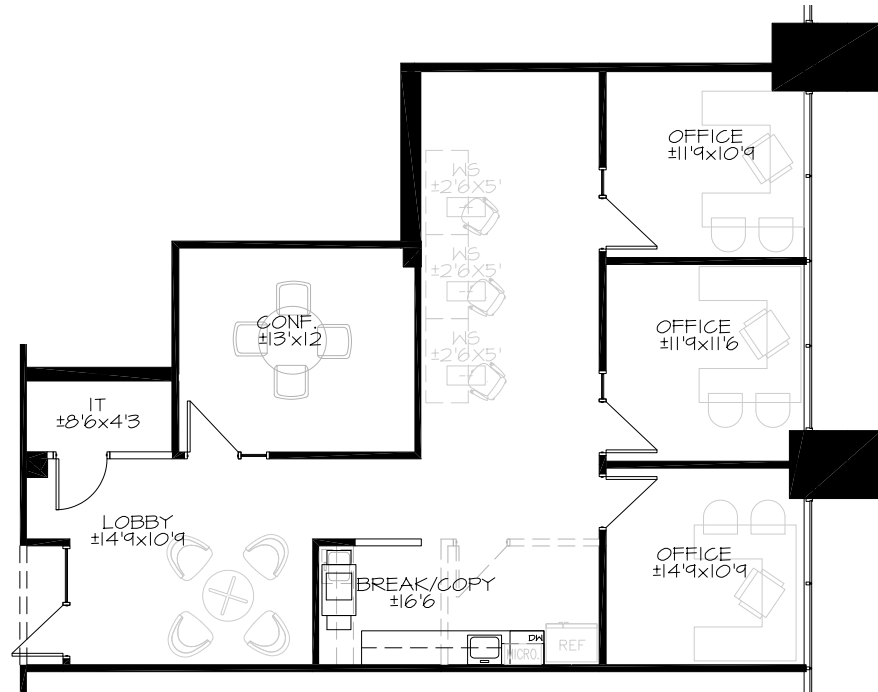

For leasing information contact

**Rachael Thompson**

602.513.5122

rachael.thompson@kidder.com

**Perry Gabuzzi, CCIM**

602.513.5116

perry.gabuzzi@kidder.com

[stapleymedicalcenter.com](http://stapleymedicalcenter.com)

